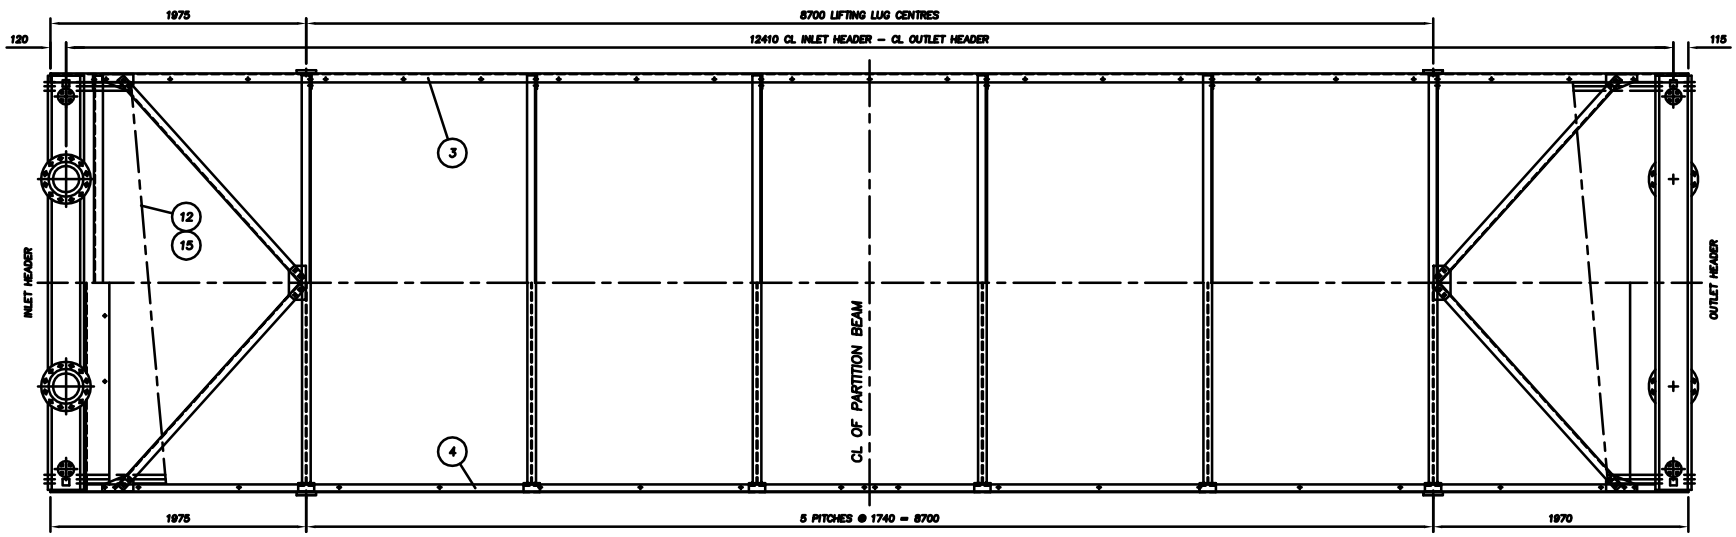


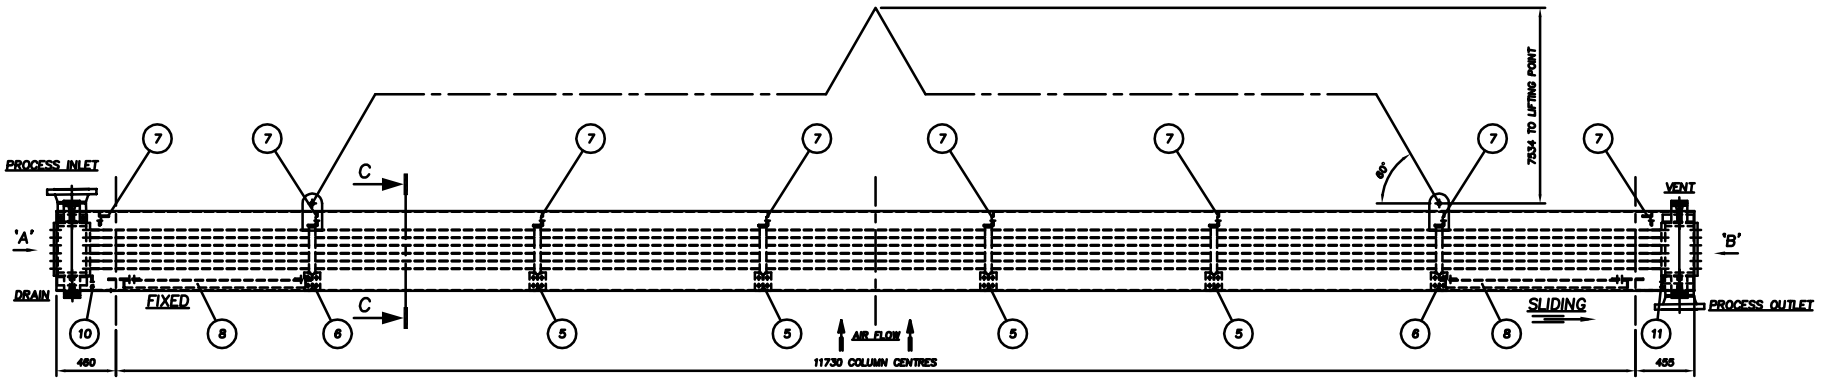


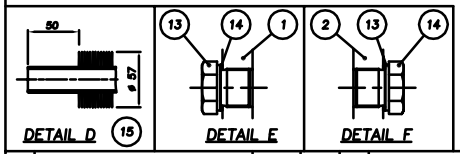


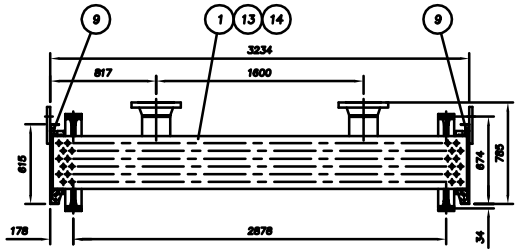


VIEW ON ARROW A

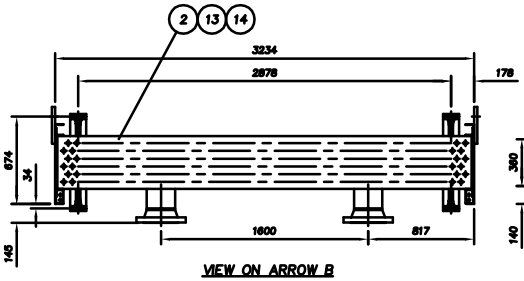


VIEW ON ARROW B

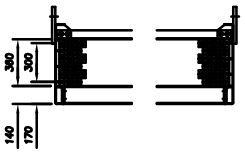


SECTION C–C

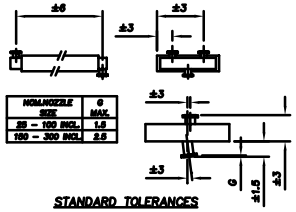


STANDARD TOLERANCES

| REV | DESCRIPTION | DATE | SIG |
|---|---|---|---|
| | | | |

| REV | DESCRIPTION | DATE | SIG |
|---|---|---|---|
| | | | |

| REV | DESCRIPTION | DATE | SIG |
|---|---|---|---|
| A | FOR APPROVAL | 31.01.03 | |
| B | AS BUILT | 21.07.03 | |

THIS DRAWING IS THE PROPERTY OF POOLE PROCESS EQUIPMENT Ltd., & MUST NOT BE REPRODUCED OR CIRCULATED FOR ANY PURPOSE WHATSOEVER WITHOUT FIRST OBTAINING WRITTEN CONSENT FROM THE COMPANY.

3RD ANGLE PROJECTION

DO NOT SCALE
IF IN DOUBT ASK

| | |
|---|---|
| ORIG. | P.M.L. |
| CHKD | |
| APP'D | |
| SCALE | 1:10 |
| DATE | 31.01.03 |

CLIENT

TITLE

# BUNDLE ARRANGEMENT FOR REPLACEMENT ULTRAFORMER REACTOR EFFLUENT BUNDLE 0207–03

POOLE PROCESS EQUIPMENT Ltd.
THRUXTON HOUSE
NUFFIELD ROAD
NUFFIELD IND. EST.
POOLE, DORSET,
BH17 0RA.
Tel: (01202) 674683
Fax: (01202) 665265

| PROJ. | DRG. | REV |
|---|---|---|
| | | |